

05/07/2015 14:05 2077918000

PAGE 05/05

Form 4503

Notification: 10300108374

Work Order: 801000041322

## LOCATION PERMIT

Upon the Application of Center Maine Power Company and N/A  
dated May 6, 2015, asking for permission, in accordance with law, to construct and  
maintain poles, buried cables, conduits, and transformers, together with attached facilities and appurtenances  
over, under, along or across certain highways and public roads in the location described in said application,  
permission is hereby given to construct, reconstruct, maintain and relocate in substantially the same location,  
said facilities and appurtenances in the City / Town of Cape Elizabeth  
approximately located as follows:

1. Starting Point: Corner of Fowler Rd and Hampton Rd
2. Road (State & CMP): Fowler
3. Direction: SW
4. Distance: 80 +/- feet
5. Number of Poles: na see sketch

Facilities shall consist of wood poles and appurtenances with a minimum of wire and cable not less than 18 feet over the public highway and/or buried cables or conduit and appurtenances placed a minimum depth of 36 inches under pavement and 30 inches elsewhere, all in a manner conforming to the National Electric Safety Code.

By: \_\_\_\_\_

By: \_\_\_\_\_

Municipal Officers

Office of the \_\_\_\_\_

Received and Recorded in Book \_\_\_\_\_, Page \_\_\_\_\_

Attest: \_\_\_\_\_

Clerk

05/07/2015 14:05

2077918000

PAGE 04/05

Form 4502

## CENTRAL MAINE POWER COMPANY

SKETCH TO ACCOMPANY APPLICATION FOR POLE OR UNDERGROUND LOCATIONS

Notification: 10300108374

Work Order: 801000041322

Page of


City / Town: Cape Elizabeth

Date: May 6, 2015

Street: Fowler

By: Jon Deschenes

Facilities to consist of wood poles and appurtenances with a minimum clearance of wire and cables not less than 21 feet over the public highway, and/or underground facilities to consist of buried cables, conduits, transformers and manholes for operation at 7200 volts to ground single phase. Construction to be suitable for future operation at a voltage not to exceed 22KV to ground single phase. Right-of-way limits indicated are based on the best field information available. Poles/Pads are staked. For further information call: Jon Deschenes at Central Maine Power Company tel: 207 828-2886 . Pole/Pad spans shown are approximate.

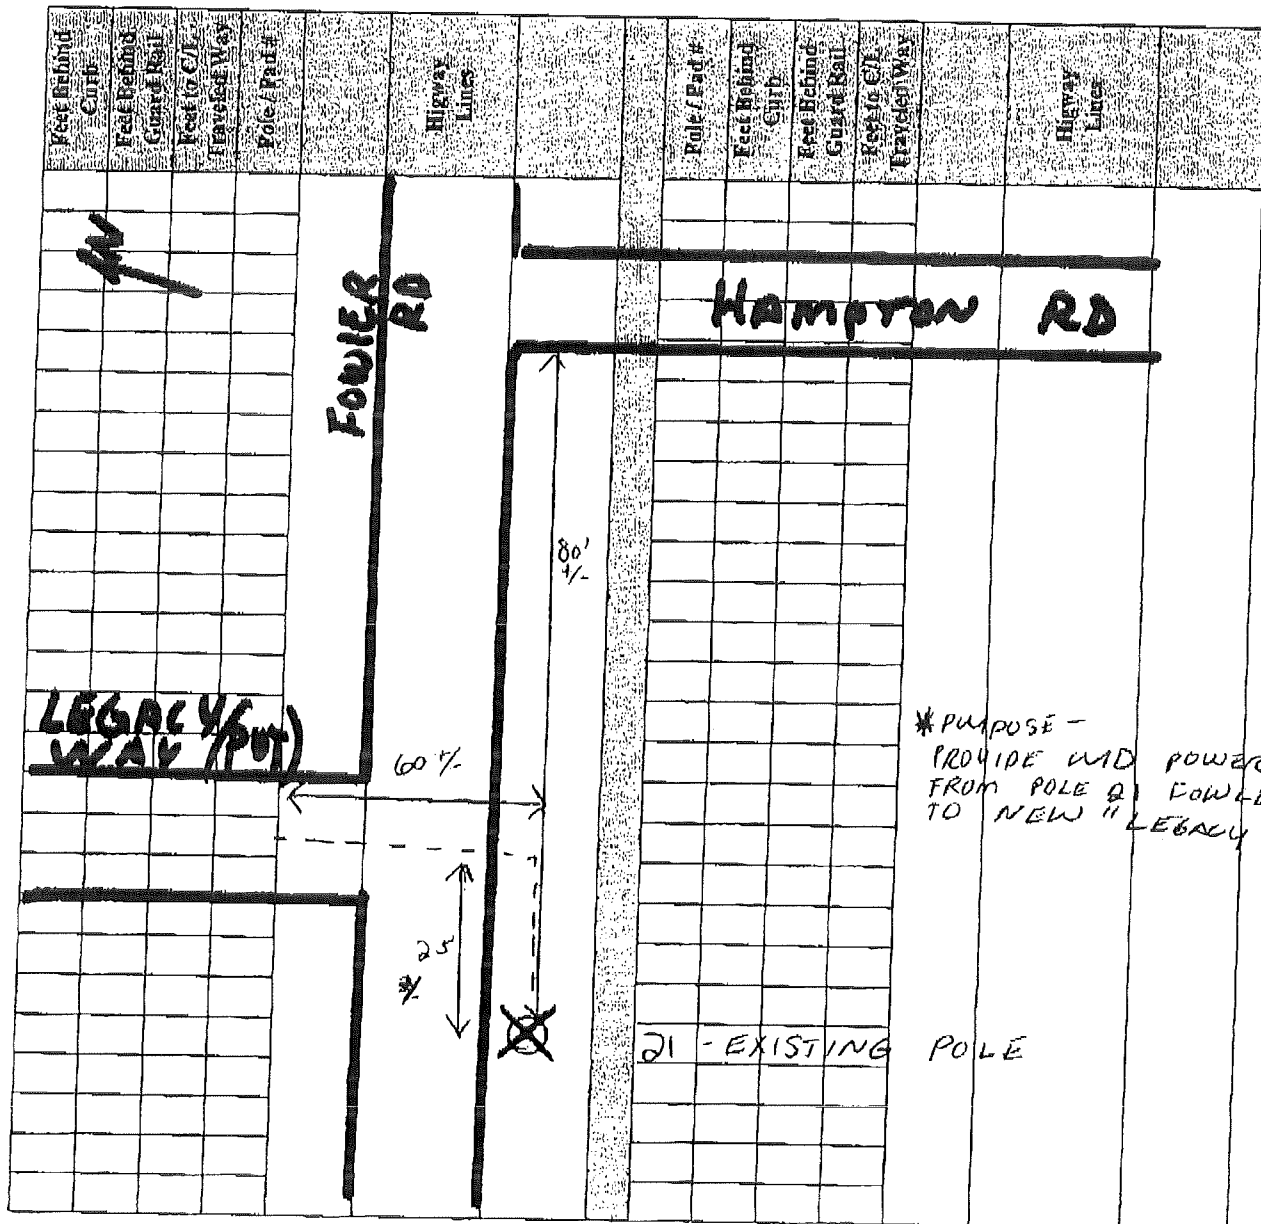

05/07/2015 14:05 2077918000

PAGE 03/05

Form 4501

Notification: 10300108374

Work Order: 801000041322

**CENTRAL MAINE POWER COMPANY  
APPLICATION FOR POLE LOCATION OR UNDERGROUND LOCATION**In the City/Town of: Cape Elizabeth, Maine

To the:

☐ City☒ Town☒ County of: Cumberland, Maine☒ Central Maine Power hereby applies for permission to:☐ Construct and maintain poles together with attached facilities and appurtenances upon, along or across certain streets and highways in said City/Town as described below.☒ Construct and maintain buried cables, conduits, manholes and handholes, together with wire and cables, transformers, cutouts, and other equipment therein, under, along, and across certain streets and highways in said City/Town as described below.☒ Central Maine Power Company andN/A

jointly apply for permission to construct and maintain poles together with attached facilities and appurtenances upon, along or across certain streets and highways in said City/Town as described below.

1. Starting Point: Corner of Fowler Rd and Hampton Rd2. Road (State & CMP): Fowler3. Direction: SW4. Distance: 80 +/- feet5. Number of Poles: na see sketch☐ Overhead wires shall have a minimum clearance of 18 feet over the public highway and be constructed to conform with the requirements of the National Electric Safety Code.☒ Buried cable facilities shall be placed at a minimum depth of 36 inches under pavement and 30 inches elsewhere and be constructed to conform with the requirements of the National Electric Safety Code.

Any person, firm, or corporation to be adversely affected by this proposed location shall file a written objection with the State Department of Transportation, City, Town or County stating the cause of said objection within fourteen (14) days after the publication of this notice or ninety (90) days after installation of facilities without publication.

☐ Public Notice of this application has been given by publishing the text of the same☒ Not PublishedIn: On: 

CENTRAL MAINE POWER COMPANY

N/ABy: Jon DeschenesDate: May 6, 2015By:  Date: